


KEY PLAN



Leasing Contact: Greg Frankum 404.842.6565 | Matt Spickard 404.842.6566

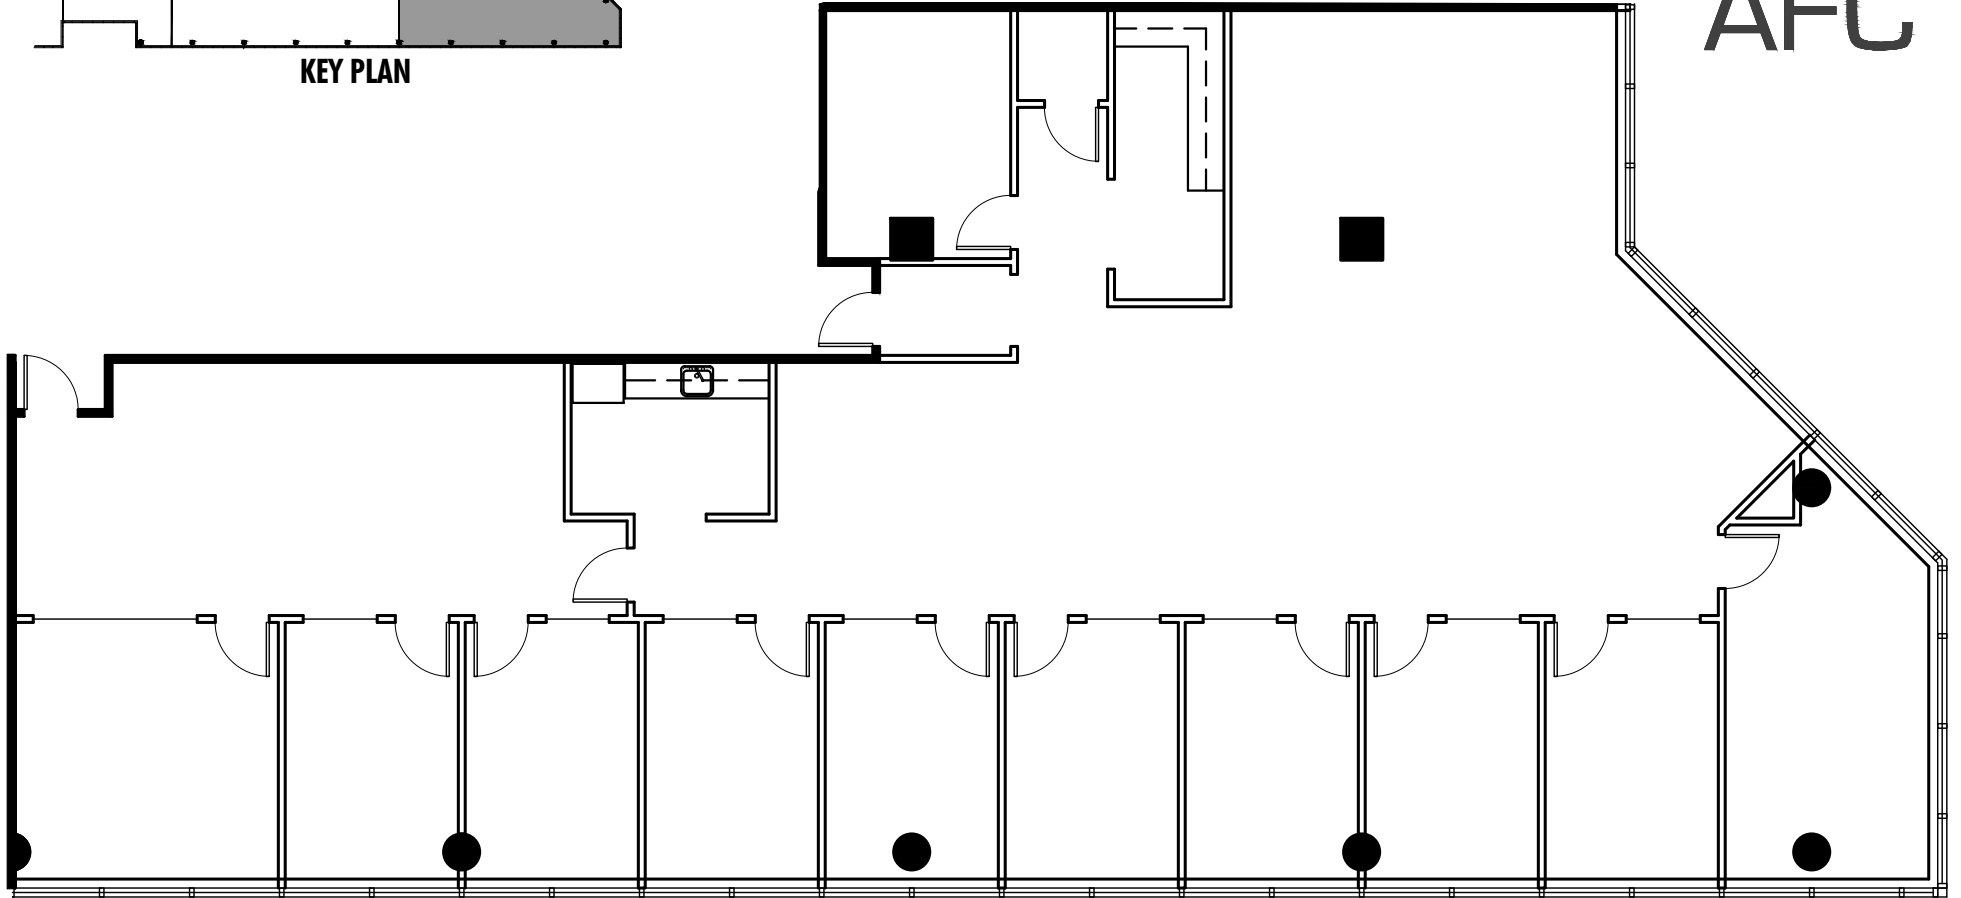

AFC North Tower • Suite 1130 • 4,678 RSF

As-Built