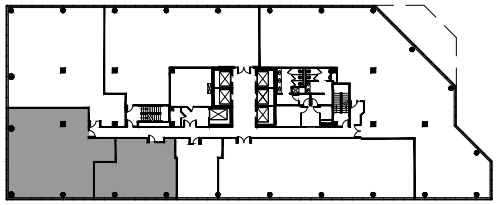

KEY PLAN

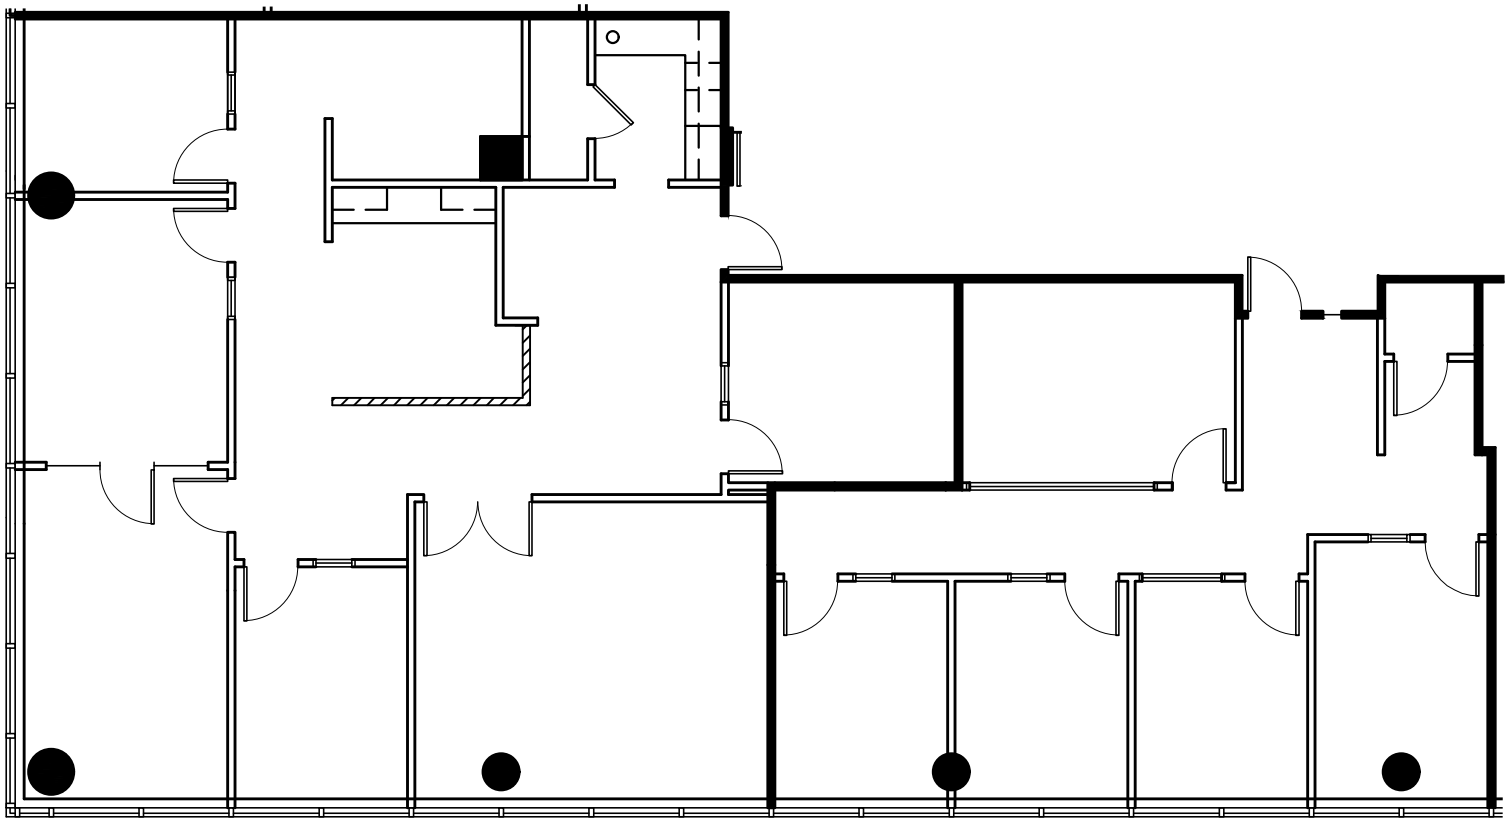

NELSON

AFC North Tower • Suite 545 • 3,509 RSF

As-Built